

NEW RIVER


PUMPKIN CENTER 5.8 km.

0.6 km TO U. S. 17

BELL FORK 1.3 km.

HUMPHREYS

277 278 279 280 281 282 283 284 285 286 20'

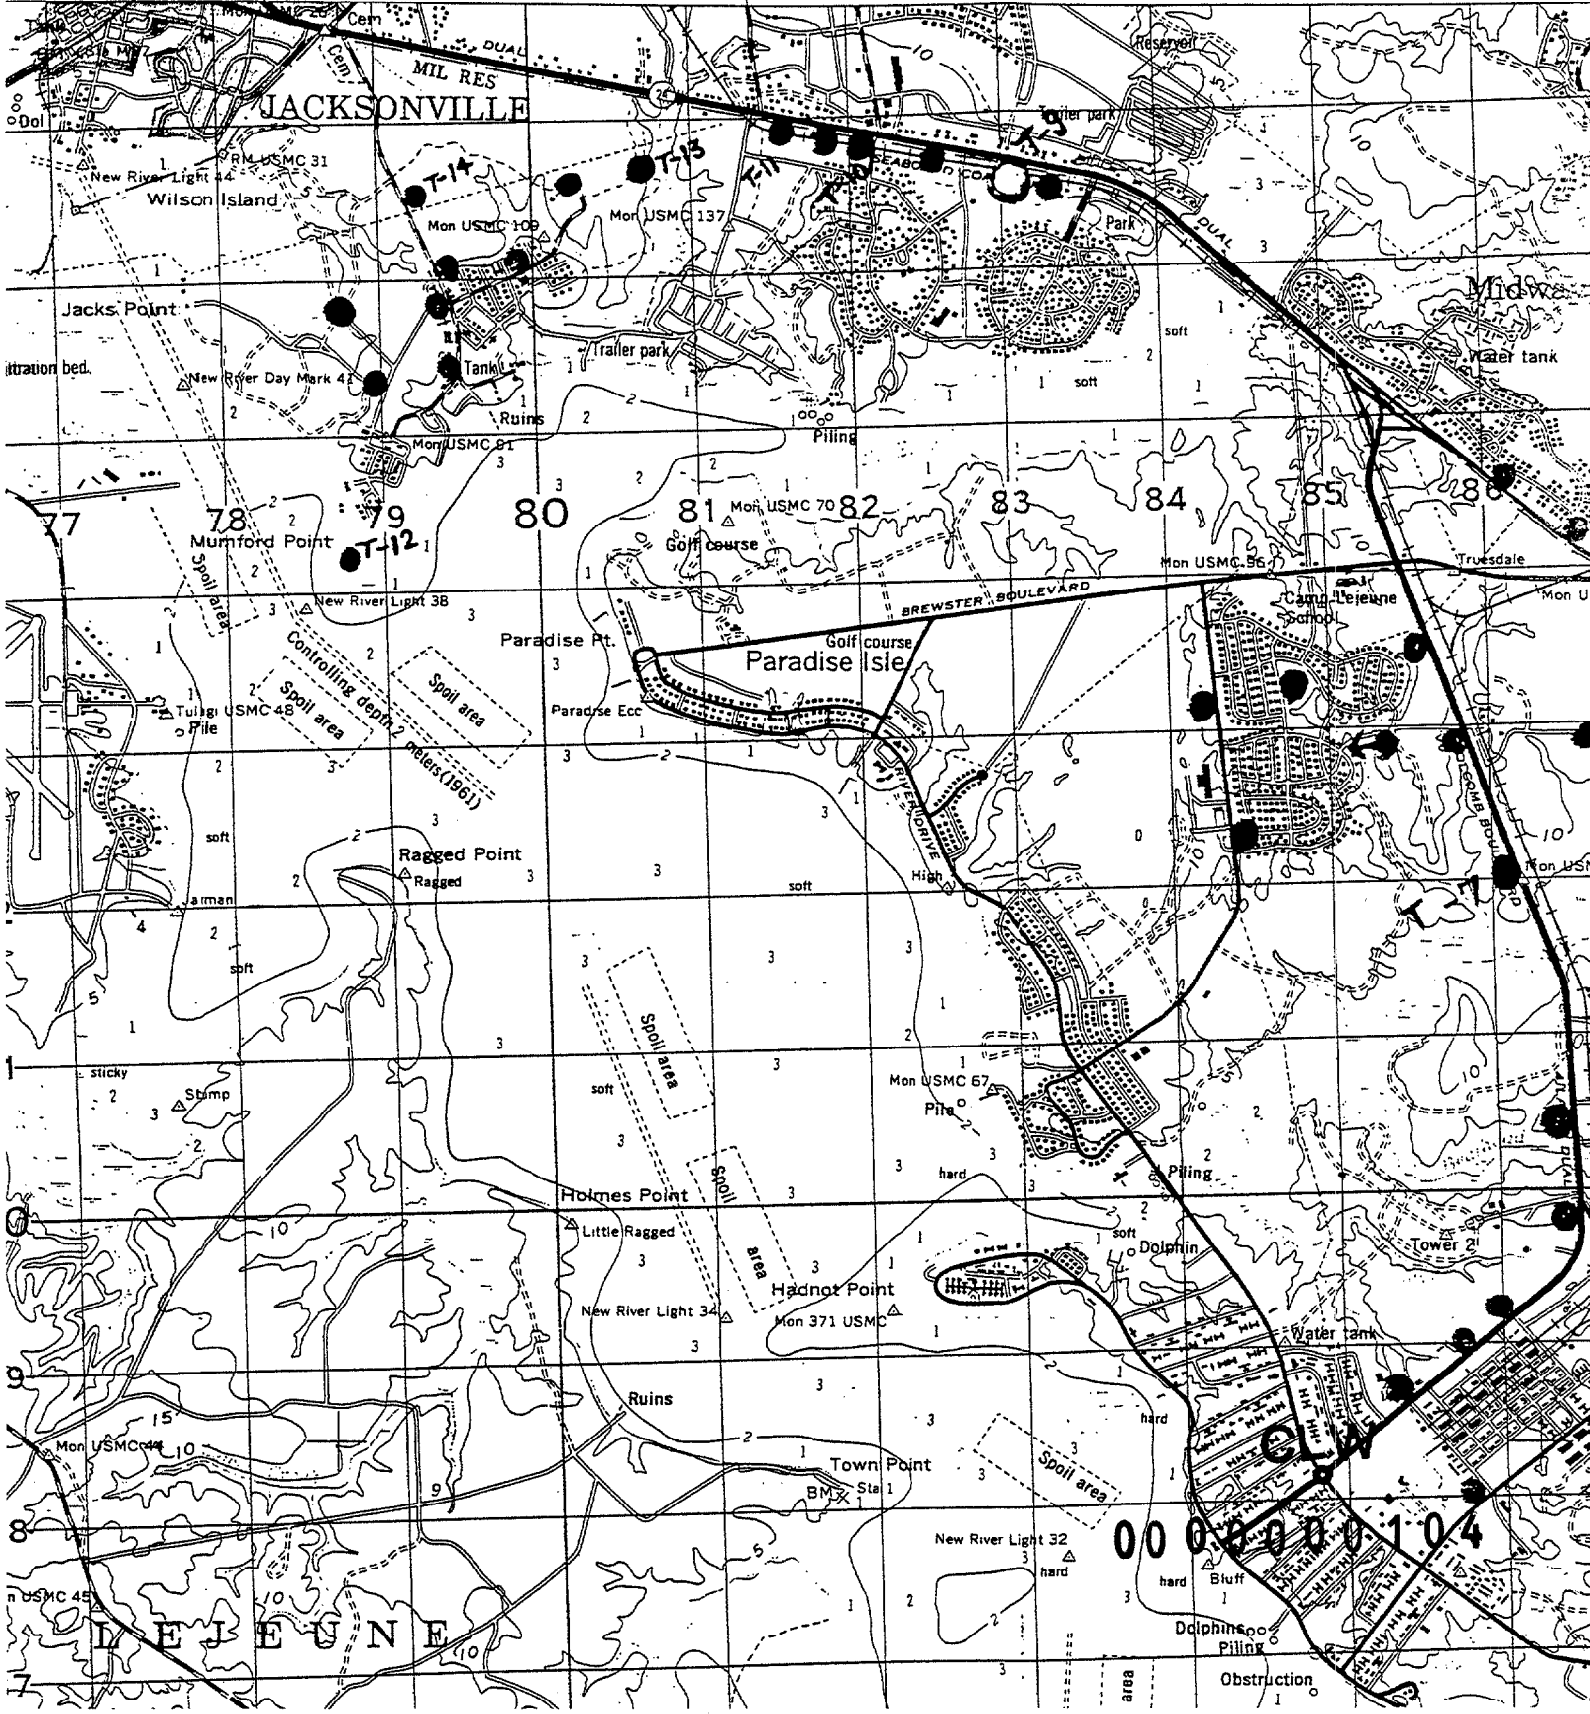

HUMPHREY 5.1 km.

MORTON FORK 13 km.

285

286

20'

287

288

289

290

291


292

293

294


77°15'

34°45'

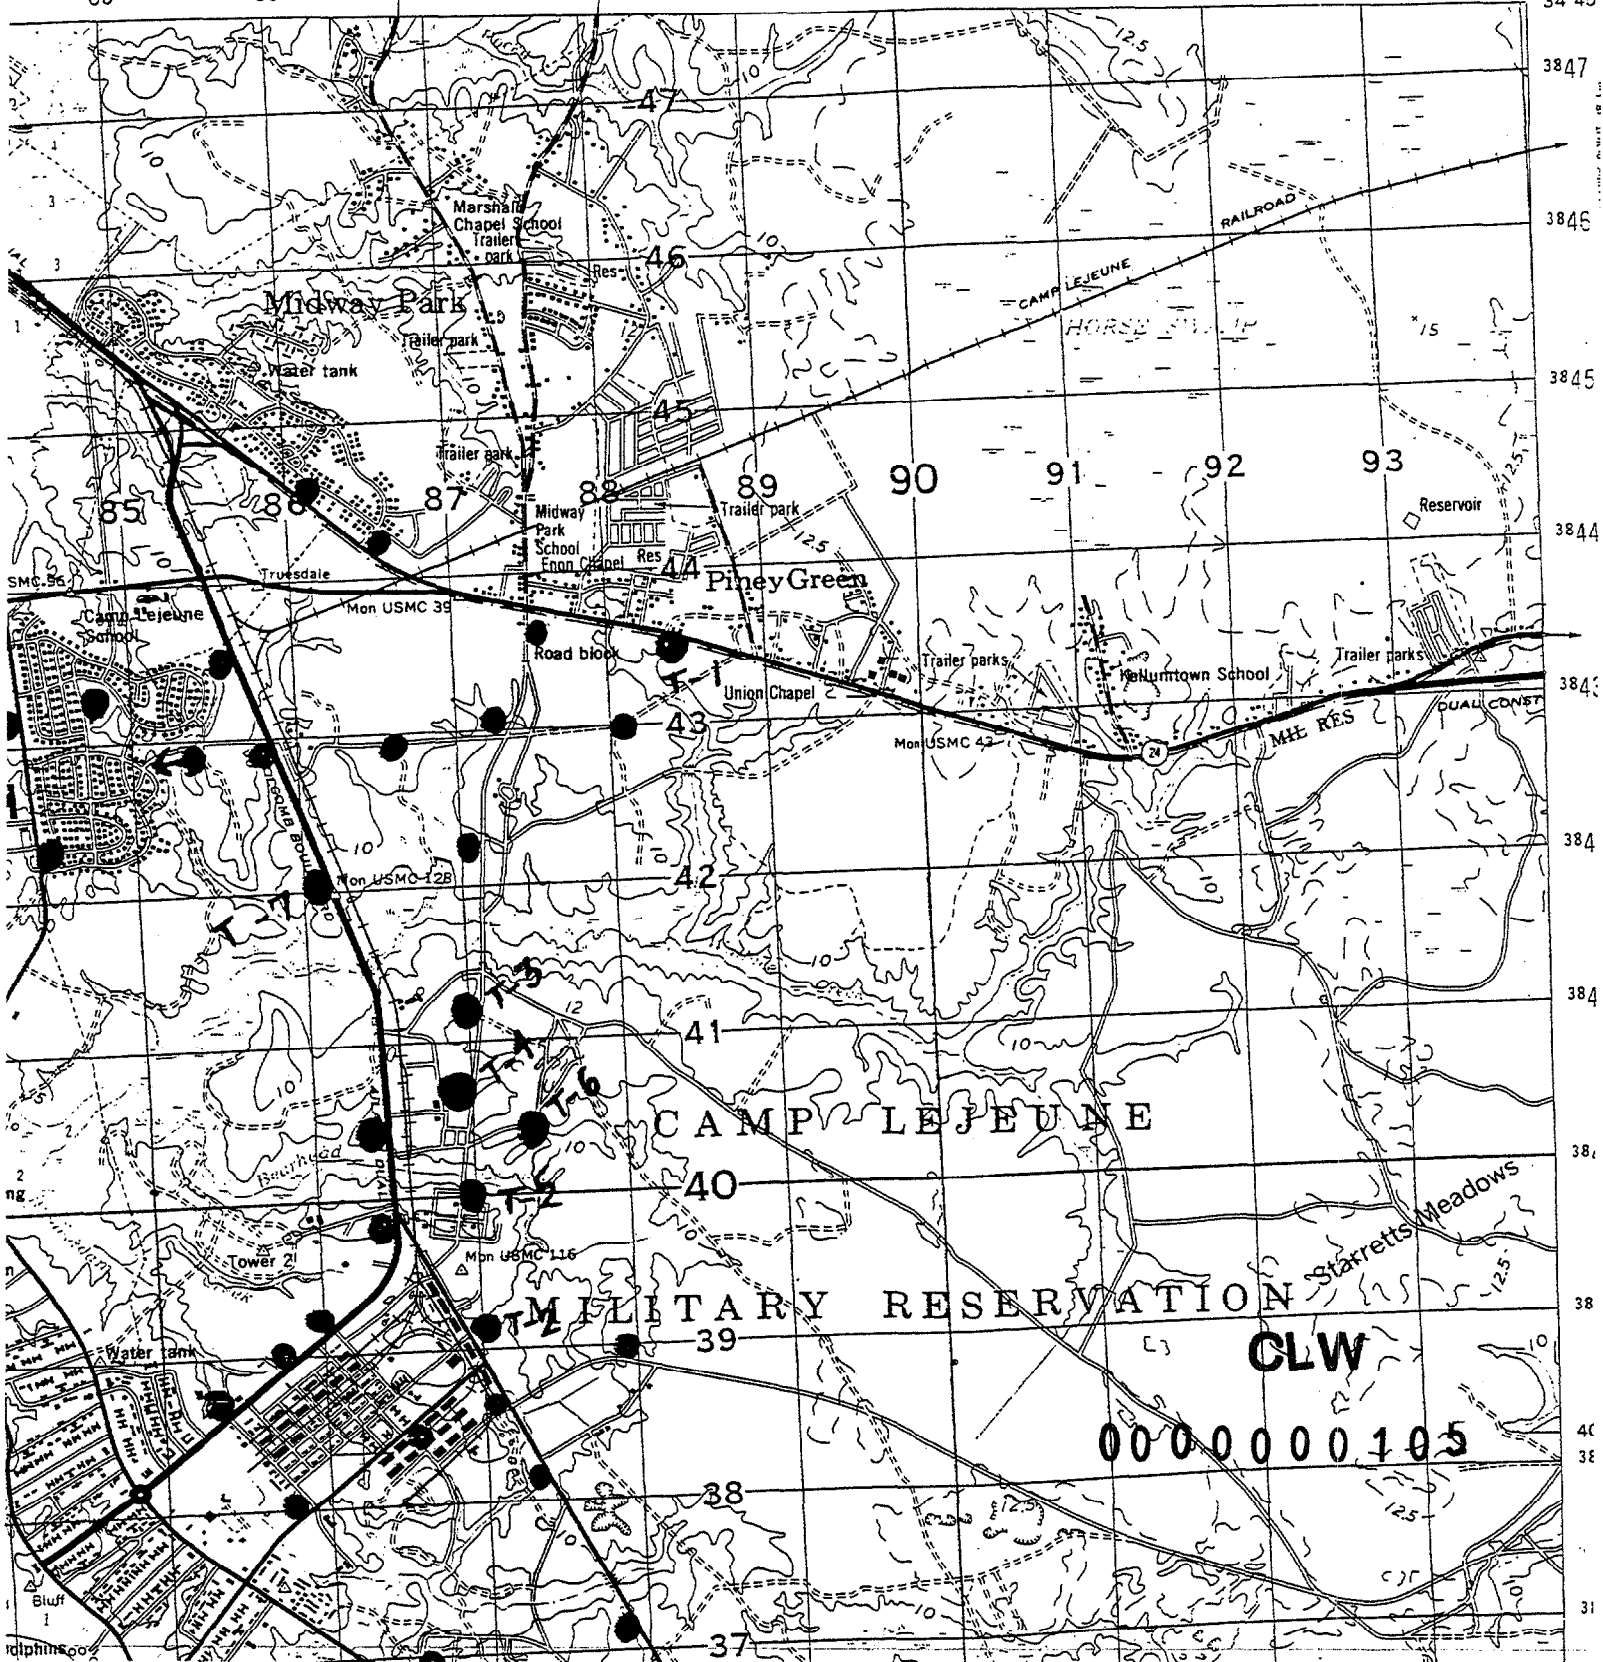


CLW

0000000105

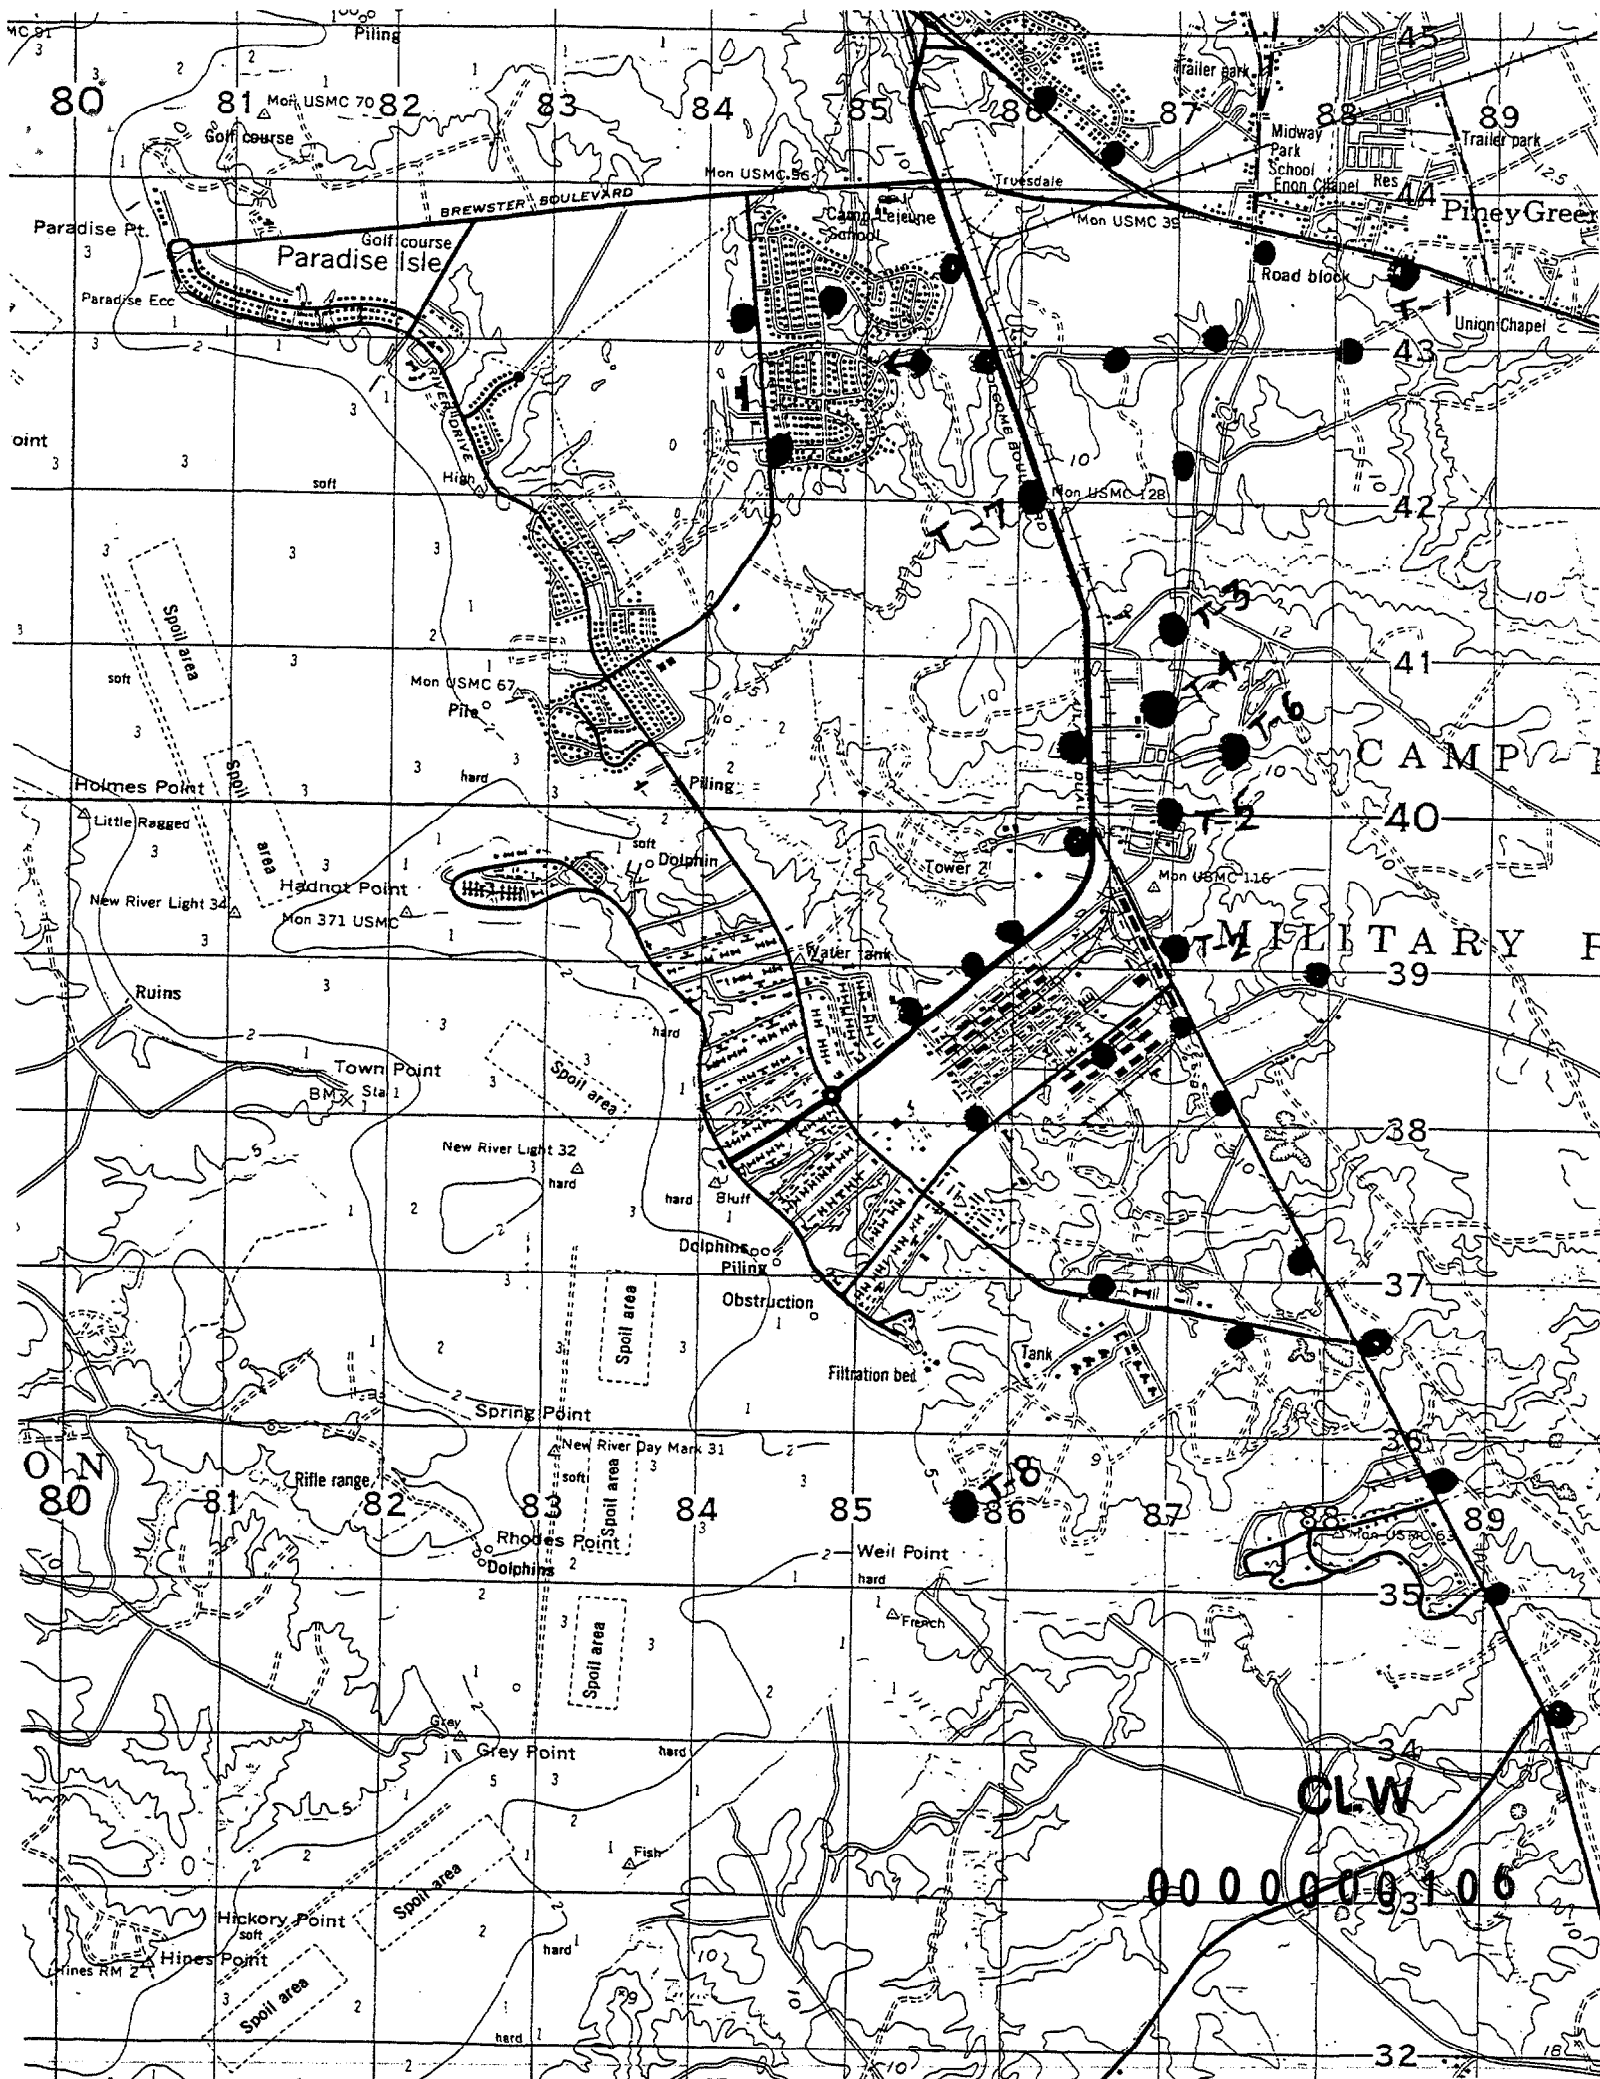


OLW

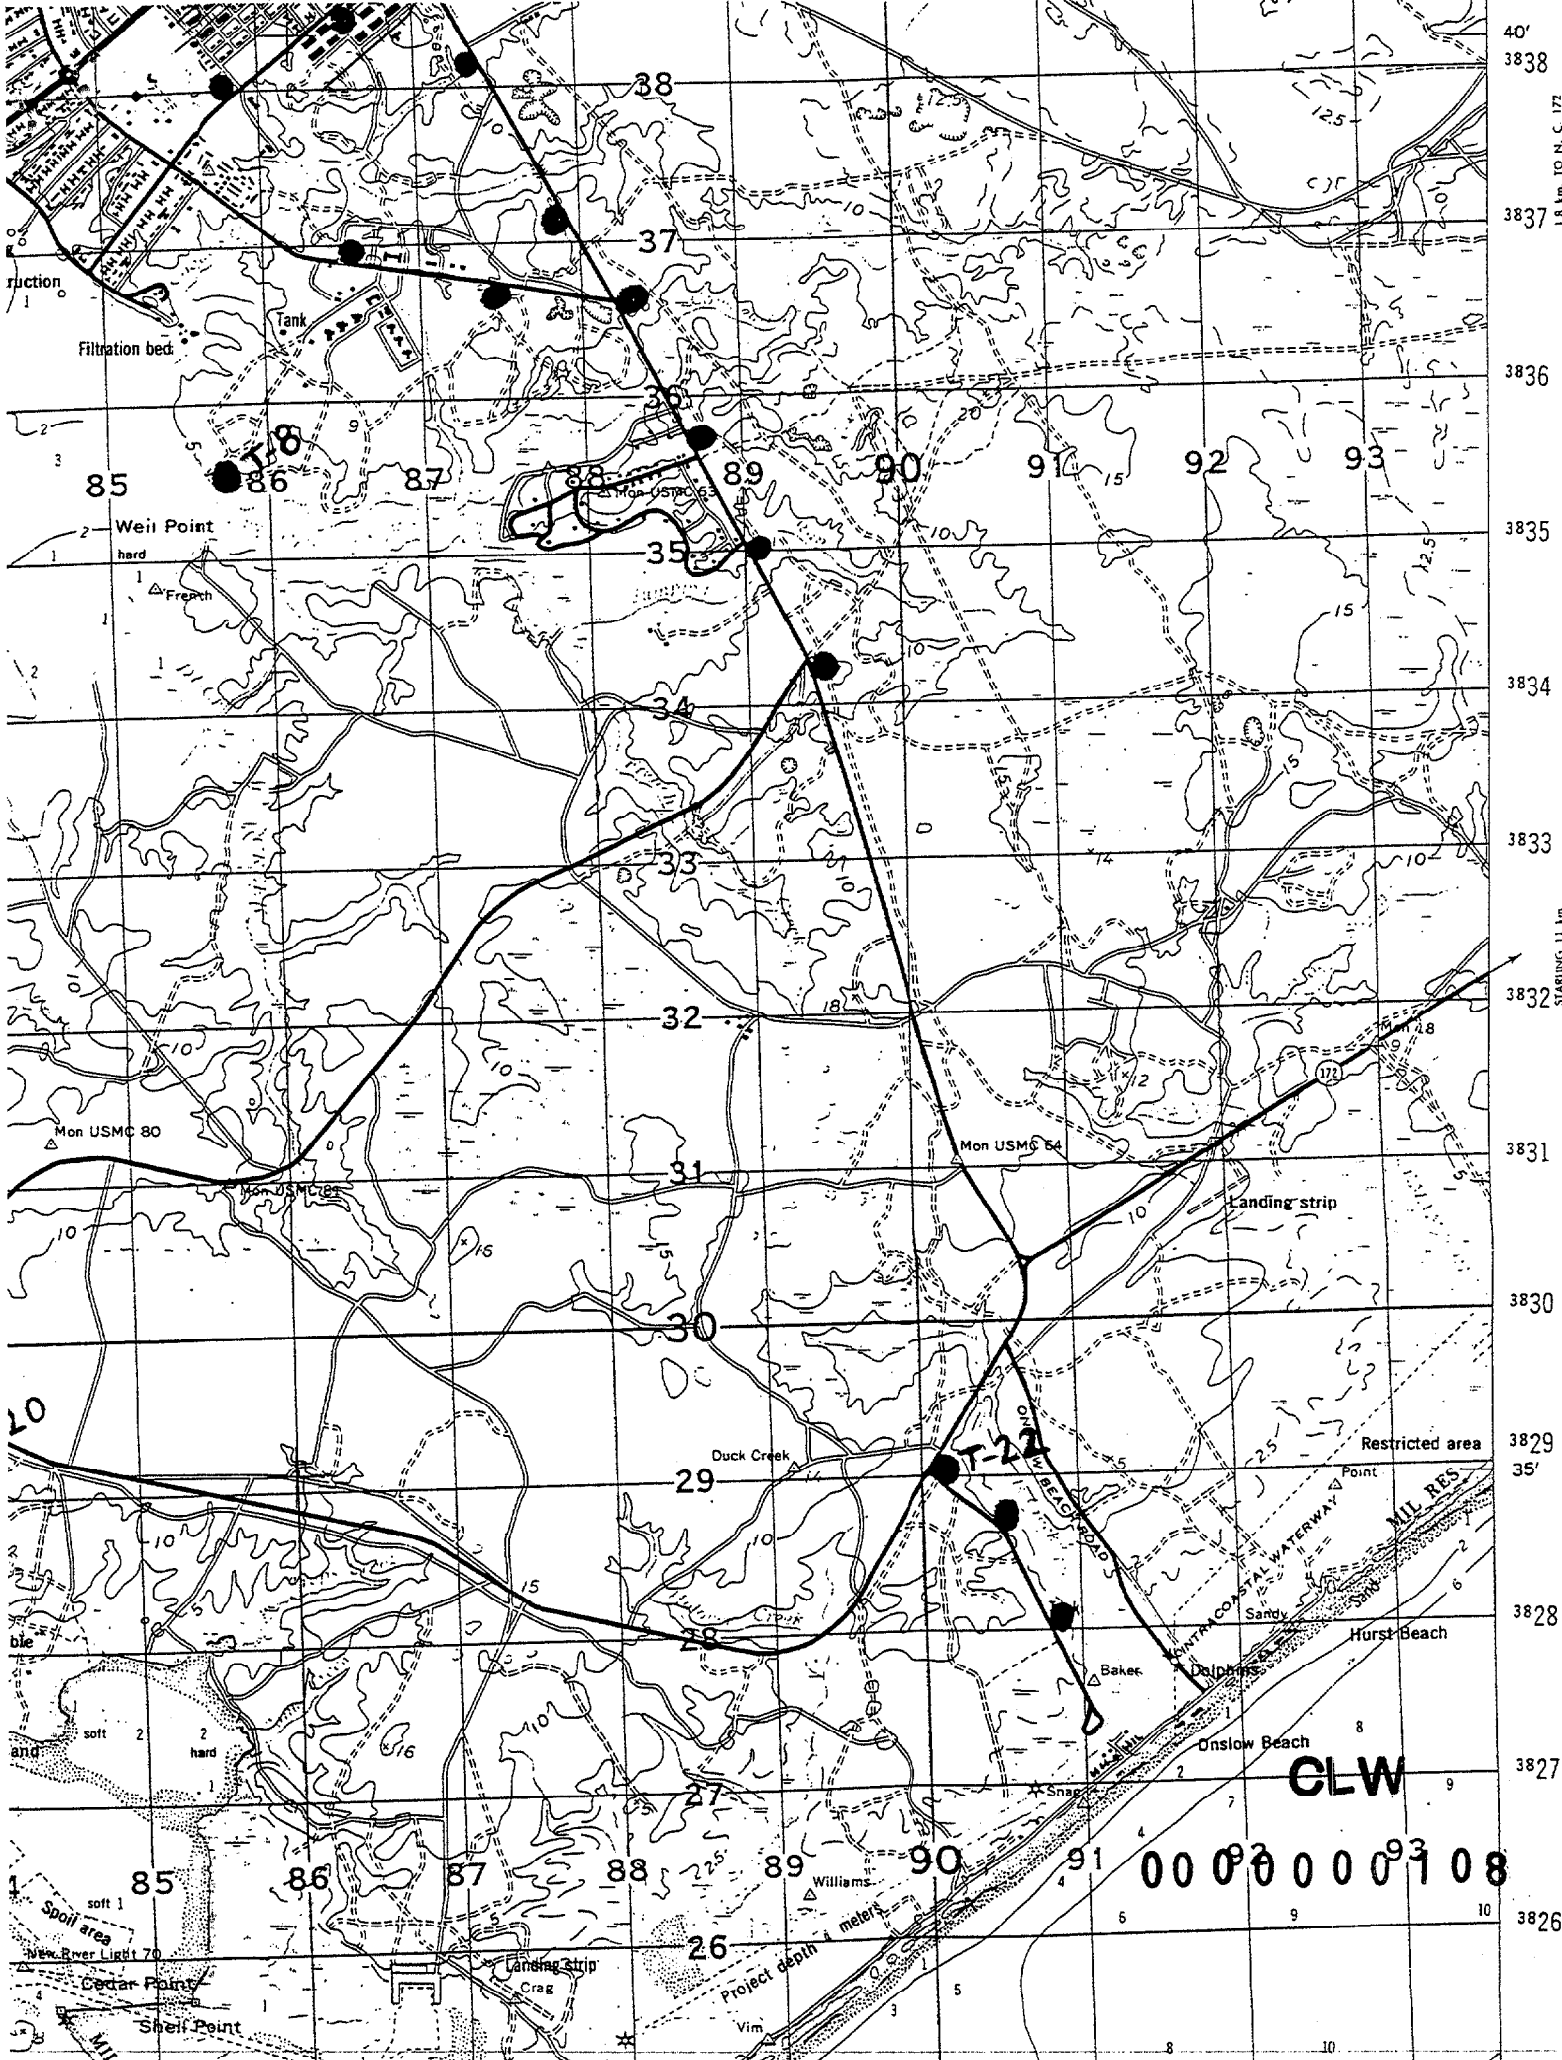


40'
3838
3837
3836
3835
3834
3833
3832
3831
3830
3829
3828
3827
3826


00000000108

CLW

1.8 km. TO N. C. 172
STARTING 11 km

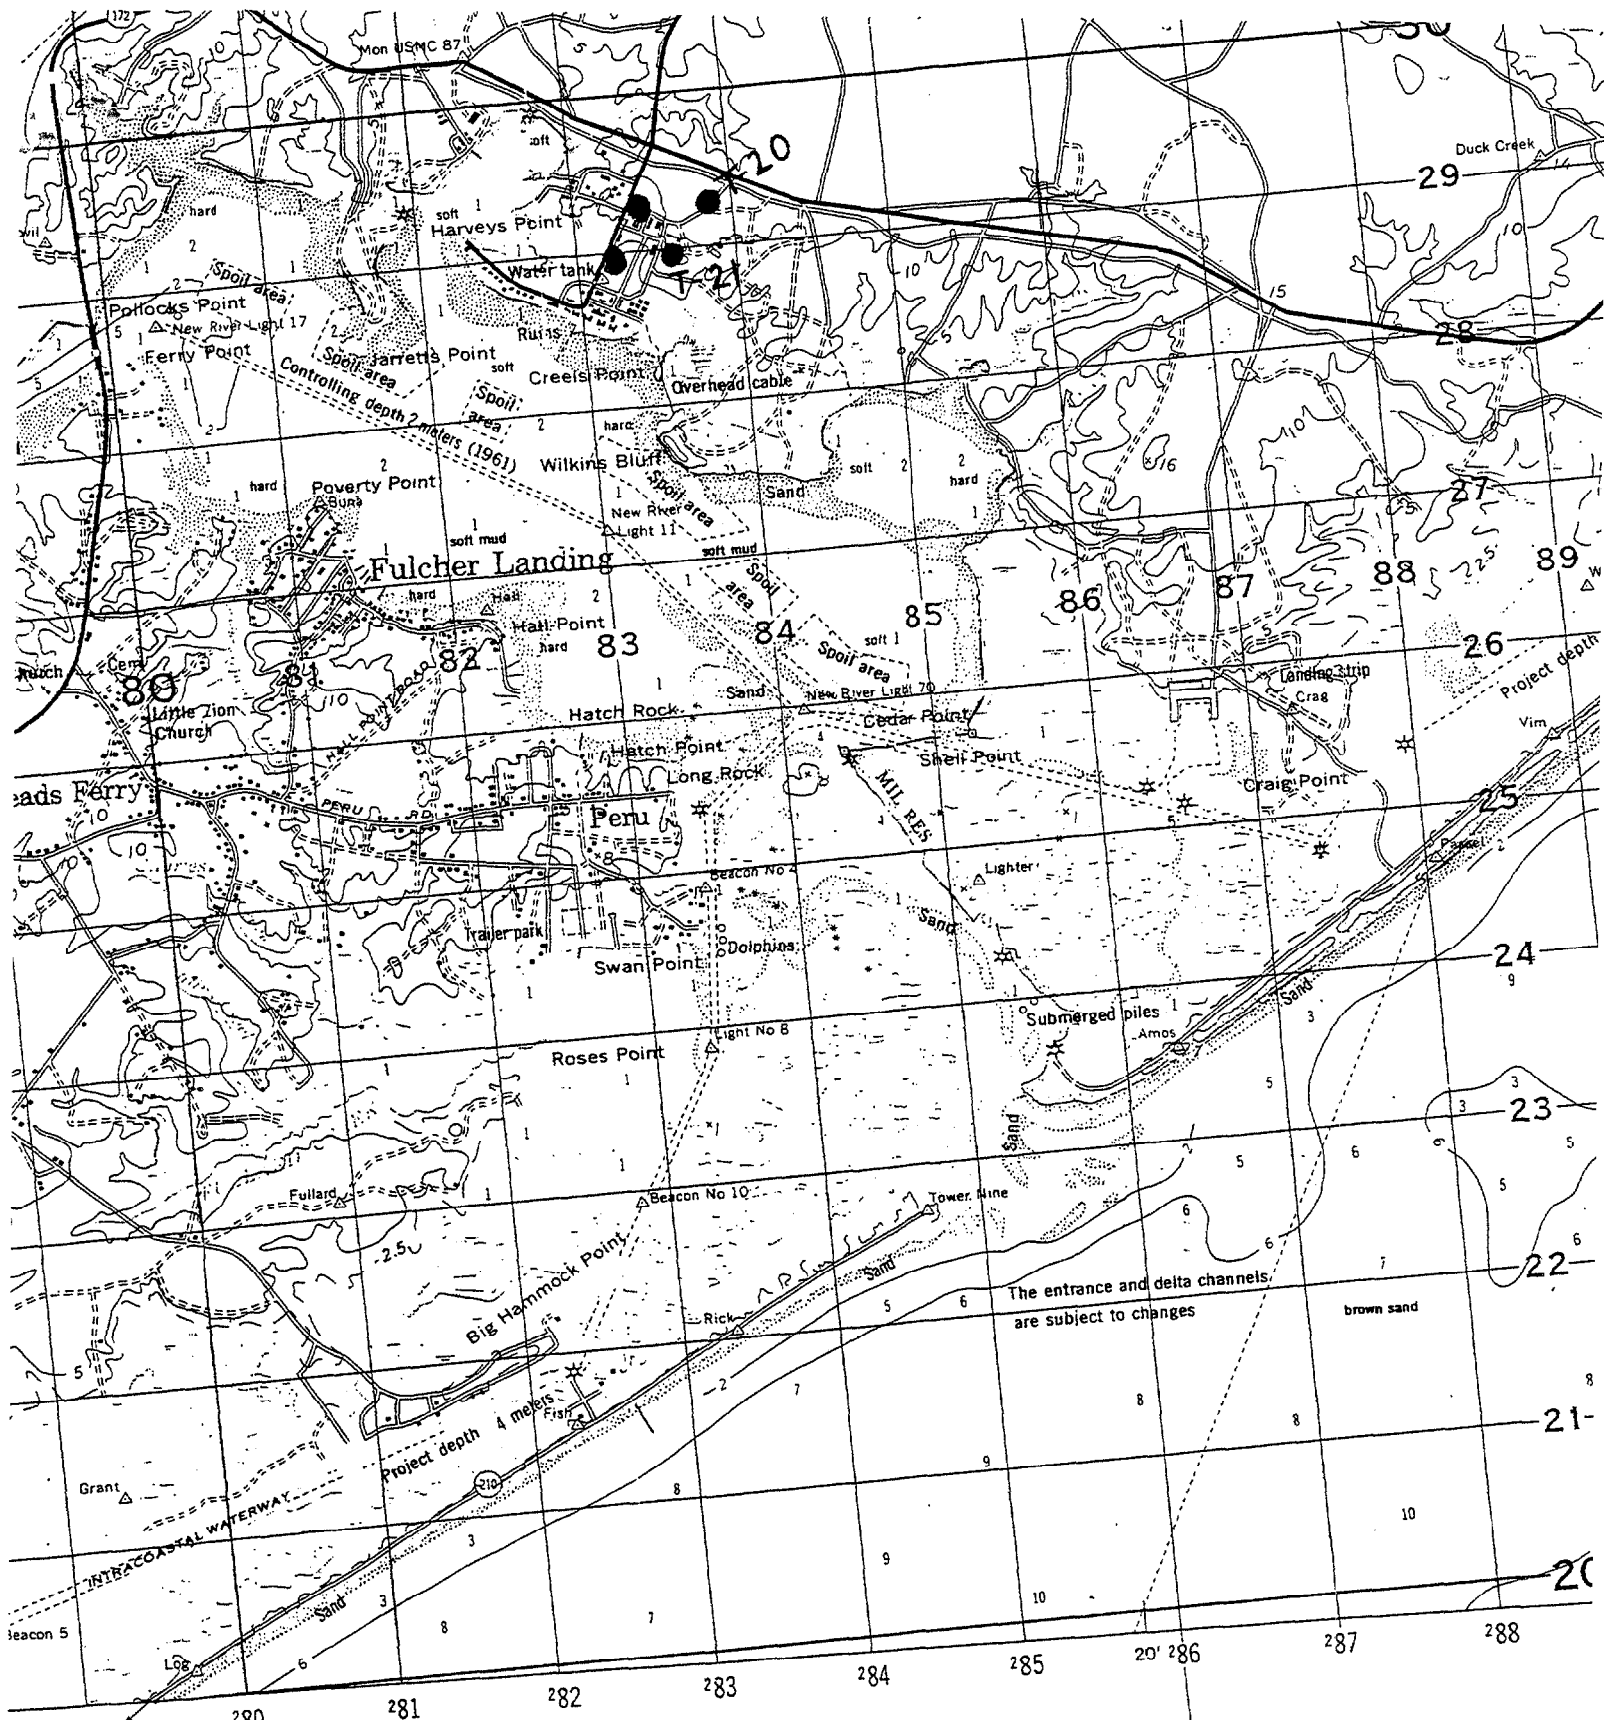

The entrance and delta channels are subject to changes
brown sand

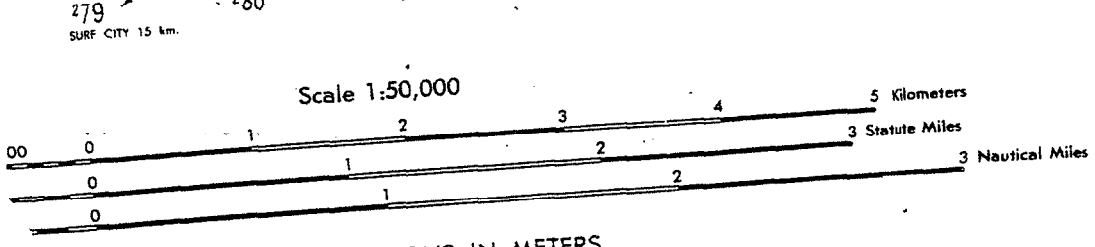

ELEVATIONS IN METERS
CONTOUR INTERVAL 5 METERS
SUPPLEMENTARY CONTOURS 2.5 METERS

MEAN LOW WATER
CLARKE 1886

CLW

0000000109

MAGNET
GRID

